
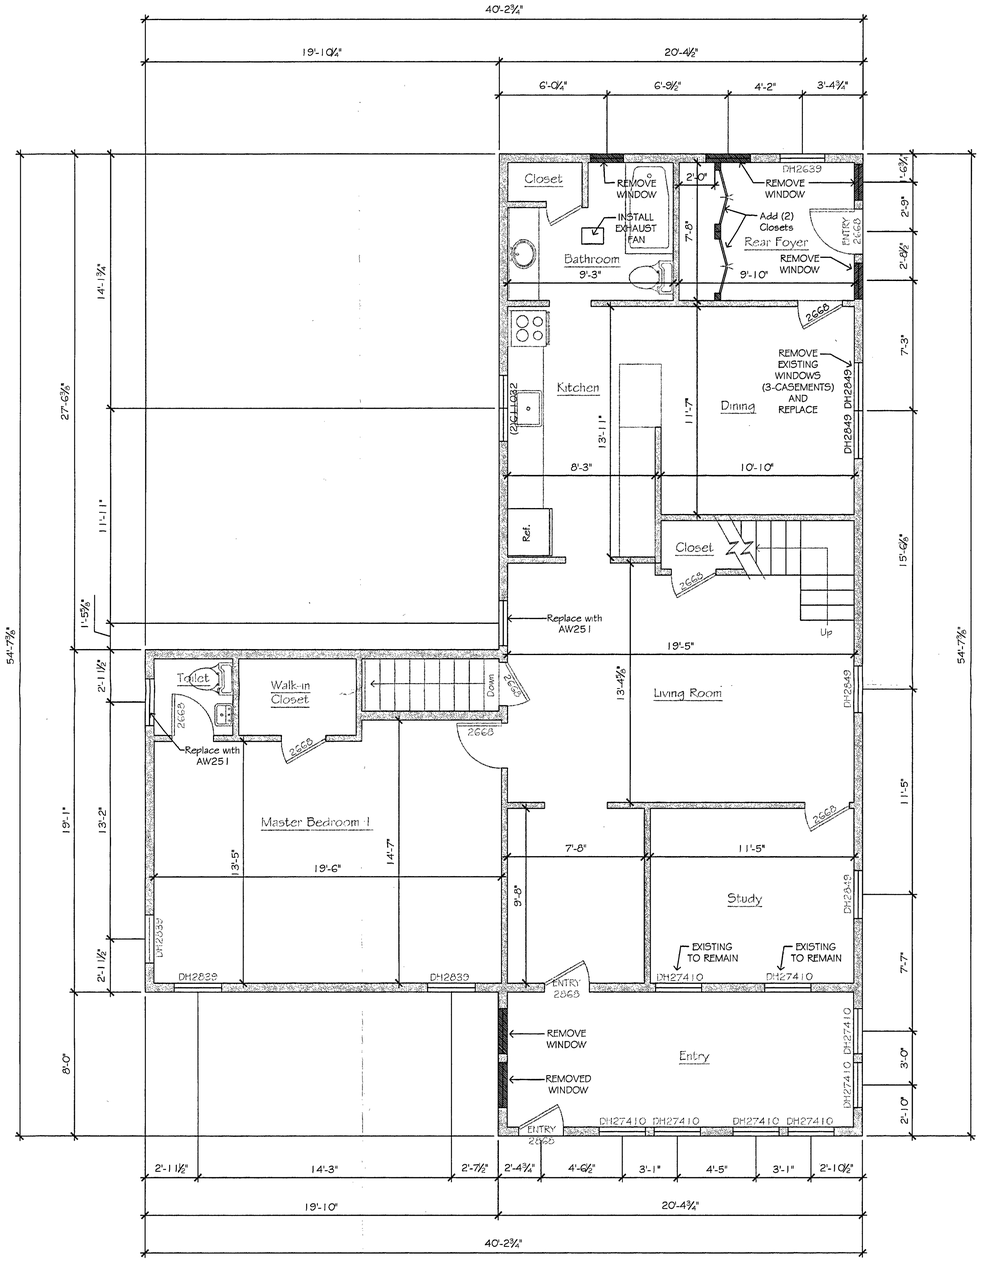



1 FIRST FLOOR PLAN - EXISTING

Scale: ¼" = 1'-0"

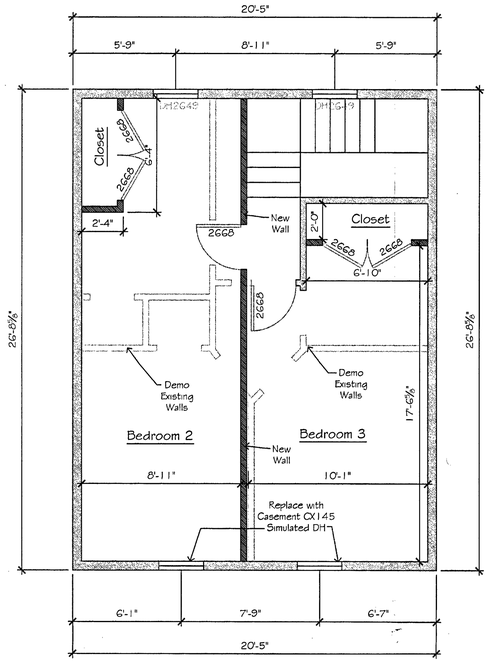

2 SECOND FLOOR PLAN - EXISTING

Scale: ¼" = 1'-0"

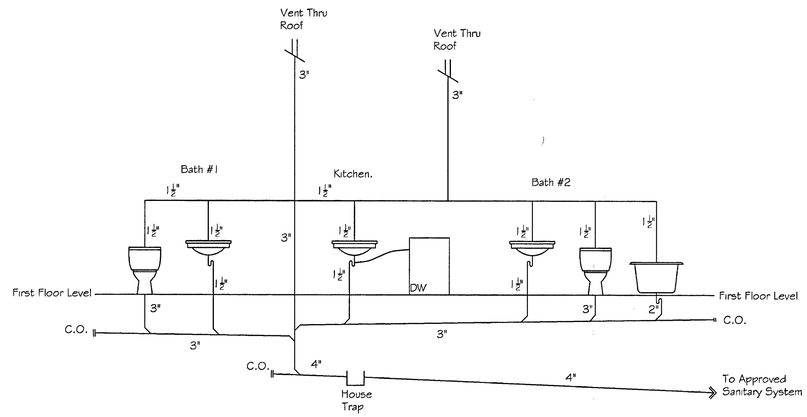

3 PLUMBING RISER - EXISTING

NTS

ELECTRICAL INSPECTION REQUIRED

OCCUPANCY OR USE IS UNLAWFUL WITHOUT CERTIFICATE OF OCCUPANCY

APPROVED AS NOTED
DATE: 5/20/18 B.P. # 380312
FEE: 344.00 BY: DAR
NOTIFY BUILDING DEPARTMENT AT 765-1802 8 AM TO 4 PM FOR THE FOLLOWING INSPECTIONS:
1. FOUNDATION - TWO REQUIRED FOR POURED CONCRETE
2. ROUGH - FRAMING & PLUMBING
3. INSULATION
4. FINAL - CONSTRUCTION MUST BE COMPLETE FOR C.O.

ALL CONSTRUCTION SHALL MEET THE REQUIREMENTS OF THE CODES OF NEW YORK STATE. NOT RESPONSIBLE FOR DESIGN OR CONSTRUCTION ERRORS.

COMPLY WITH ALL CODES OF NEW YORK STATE & TOWN CODES AS REQUIRED ~~AND CONDITIONS OF~~
- ~~SOUTHOLD TOWN ZBA~~
- ~~SOUTHOLD TOWN PLANNING BOARD~~
- ~~SOUTHOLD TOWN TRUSTEES~~
- ~~NYS DEC~~

PLUMBER CERTIFICATION ON LEAD CONTENT BEFORE CERTIFICATE OF OCCUPANCY

SOLDER USED IN WATER SUPPLY SYSTEM CANNOT EXCEED 2/10 OF 1% LEAD.

PLUMBING
ALL PLUMBING WASTE & WATER LINES NEED TESTING BEFORE COVERING

520
140
660

Office

MARK SCHWARTZ AIA
ARCHITECT
28495 MAIN ROAD
CUTCHOGUE
NEW YORK 11935
P: 631-734-4185

GEPPEL & FESTA RESIDENCE
5000 COX LANE
CUTCHOGUE, NEW YORK

NORTH

KEY PLAN

NO.	DATE	REVISIONS

COMM. NO.:	SCHWARTZ
DATE:	May 6, 2013
SCALE:	AS NOTED
DRAWN BY:	FHS
CHECKED BY:	

SHEET TITLE:
Permit Set

Bldg Dept Info

A - 1

© COPYRIGHT 2013 MARK SCHWARTZ & ASSOCIATES, ARCHITECTS